

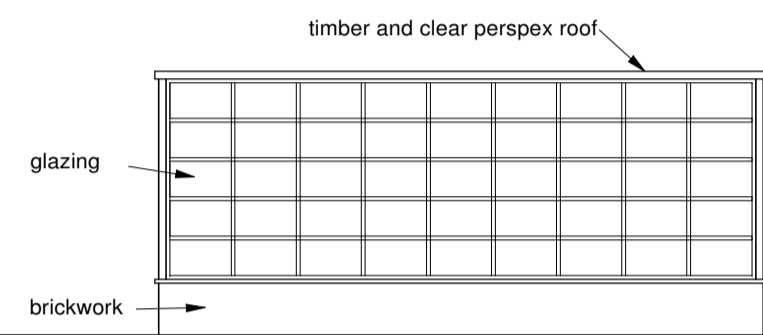



AS EXISTING:-

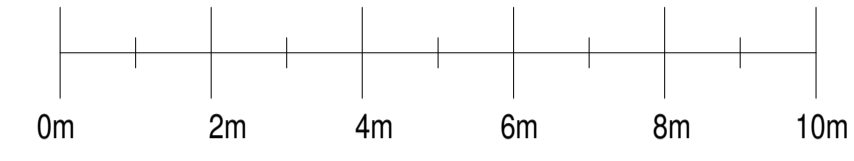


side elevation

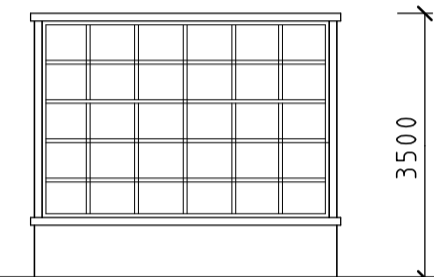


rear elevation

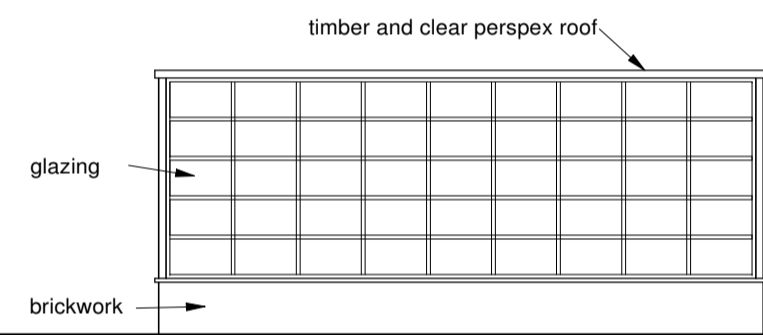


side elevation

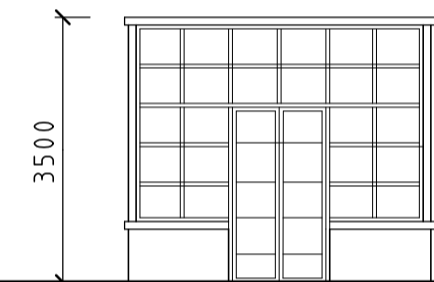

front elevation


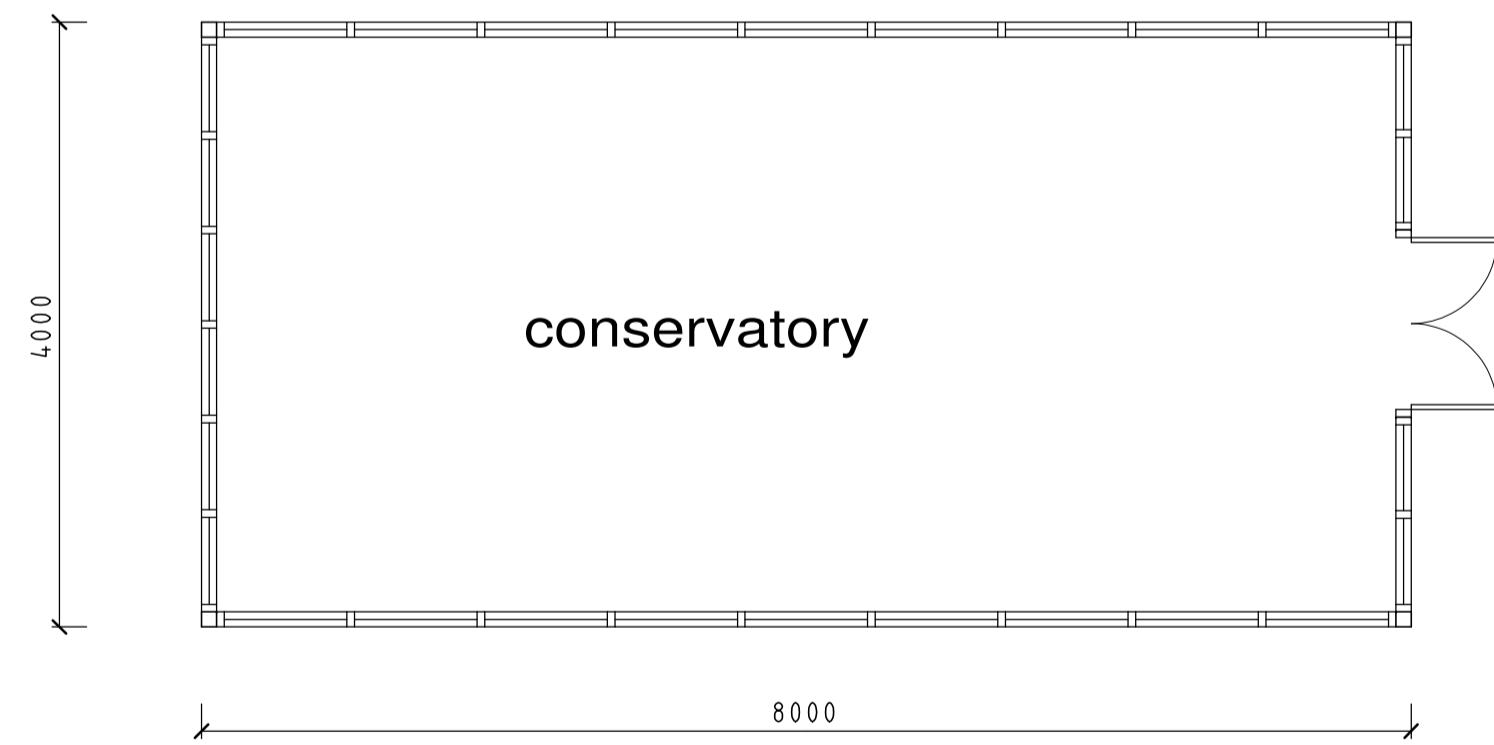


conservatory

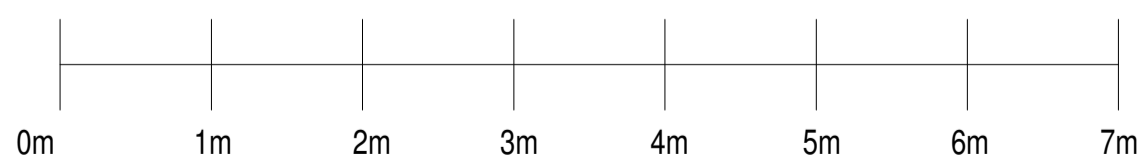


1:50 scale bar at A1


AS BUILT:-

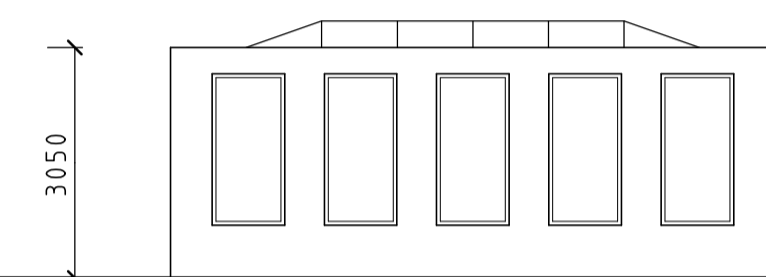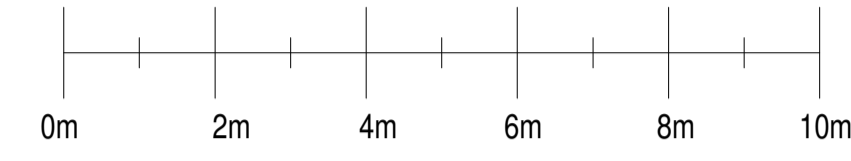


side elevation

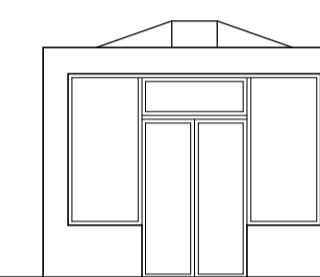


rear elevation

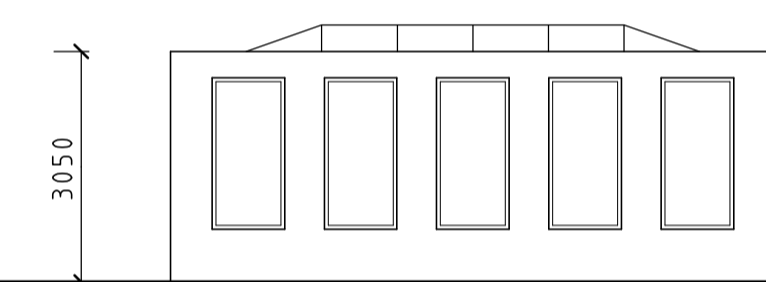

side elevation

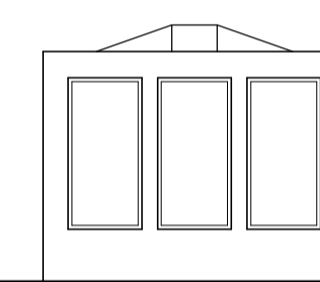

front elevation

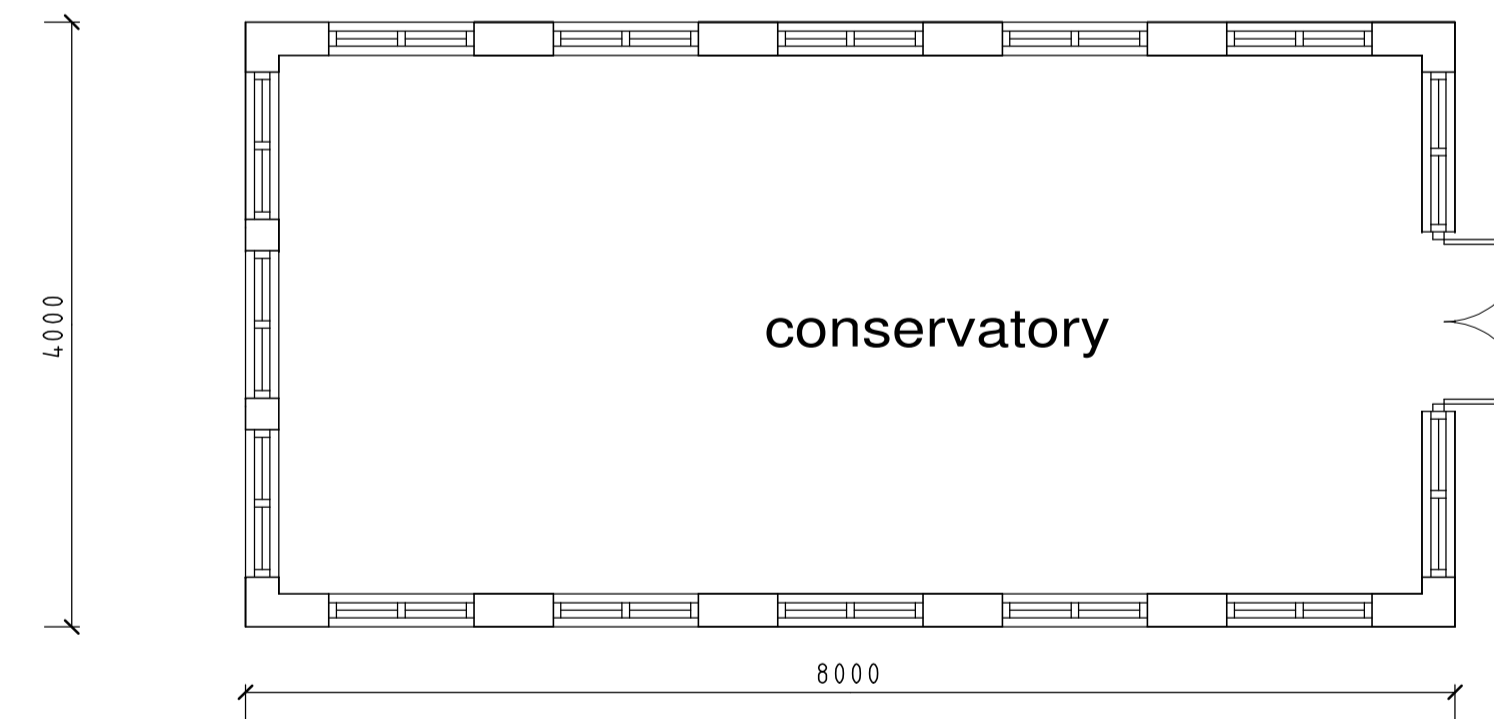

conservatory

PLAN OF:  
GREENHOUSE AT  
WHITE BARN,  
BATCHELORS LANE,  
HOLTWOOD, Nr. WIMBORNE, DORSET

DRAWN BY:	J.G.H.
DRAWING NO:	4419-BE(4)
DATE:	JANUARY 2024
SCALE:	1:50 & 1:100

**NOTE:**

1. WORK TO FIGURED DIMENSIONS ONLY. DO NOT SCALE FROM DRAWINGS. SPECIFIC DIMENSIONS AVAILABLE ON REQUEST.
2. NO THIRD PARTY LIABILITY IS GIVEN. SALE OF PROPERTY DOES NOT TRANSFER RIGHTS OF USE. AVAILABLE ON AGREEMENT.
3. COPYRIGHT EXISTS ON ALL DRAWINGS. NO REPRODUCTION IN ANY FORM IS PERMITTED WITHOUT PRIOR CONSENT.
4. ALL WORK COMMENCED PRIOR TO FORMAL BUILDING REGULATION AND / OR PLANNING APPROVAL IS ENTIRELY AT CONTRACTORS / CLIENT'S OWN RISK.
- 5.

**harriplan**  
 CHARTERED BUILDING ENGINEERS  
 25 ABBOTT ROAD, CHARMINSTER  
 BOURNEMOUTH BH9 1EU. TEL/FAX 01202 549 590  
 E-Mail: jon@harriplan.com      JON HARRISON M.C.A.B.E.

**cabe**  
 chartered  
 building engineer