


as built:




ground floor


as built:

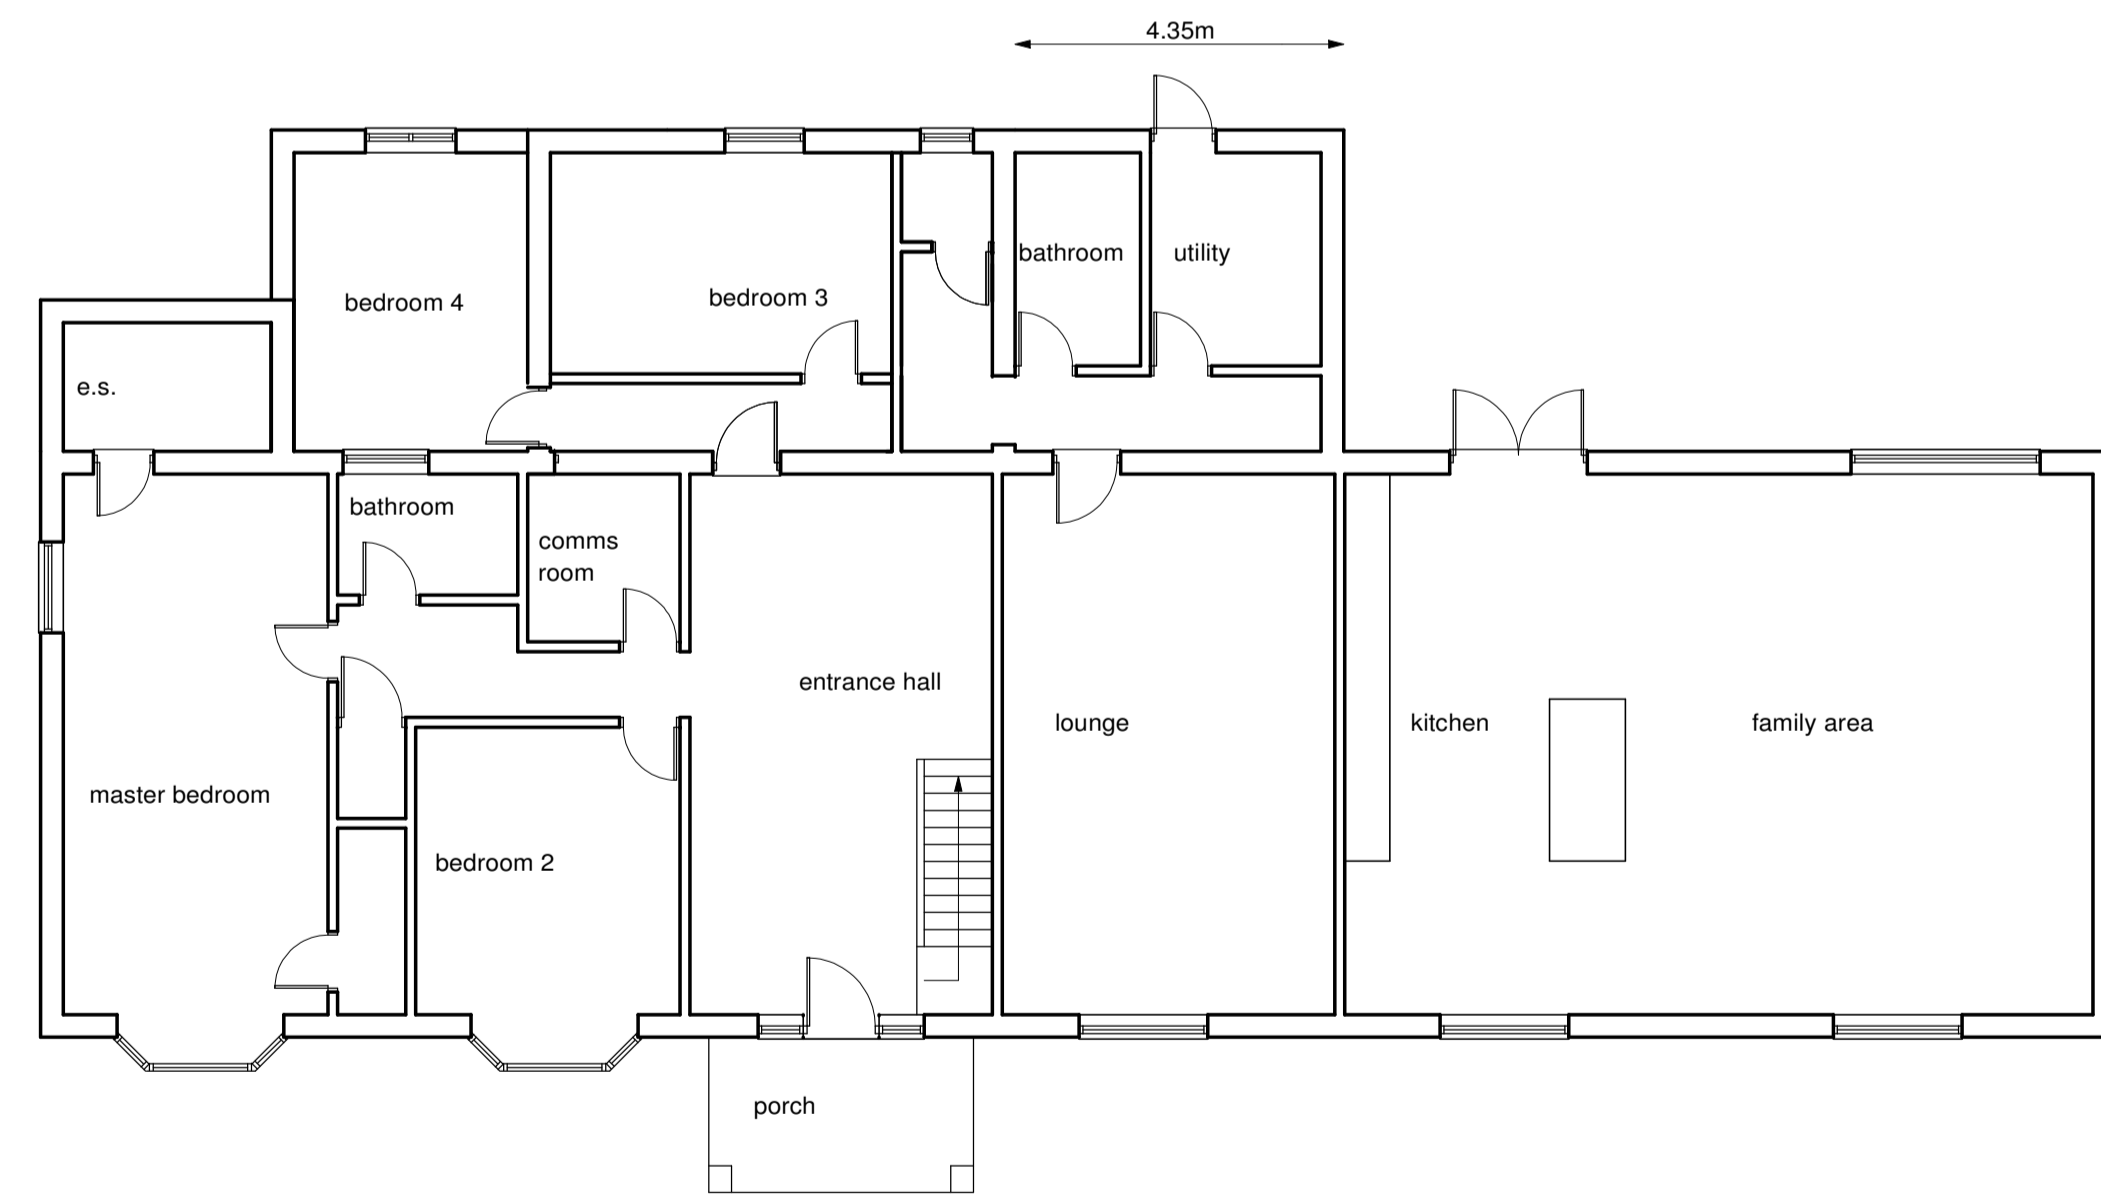

ground floor

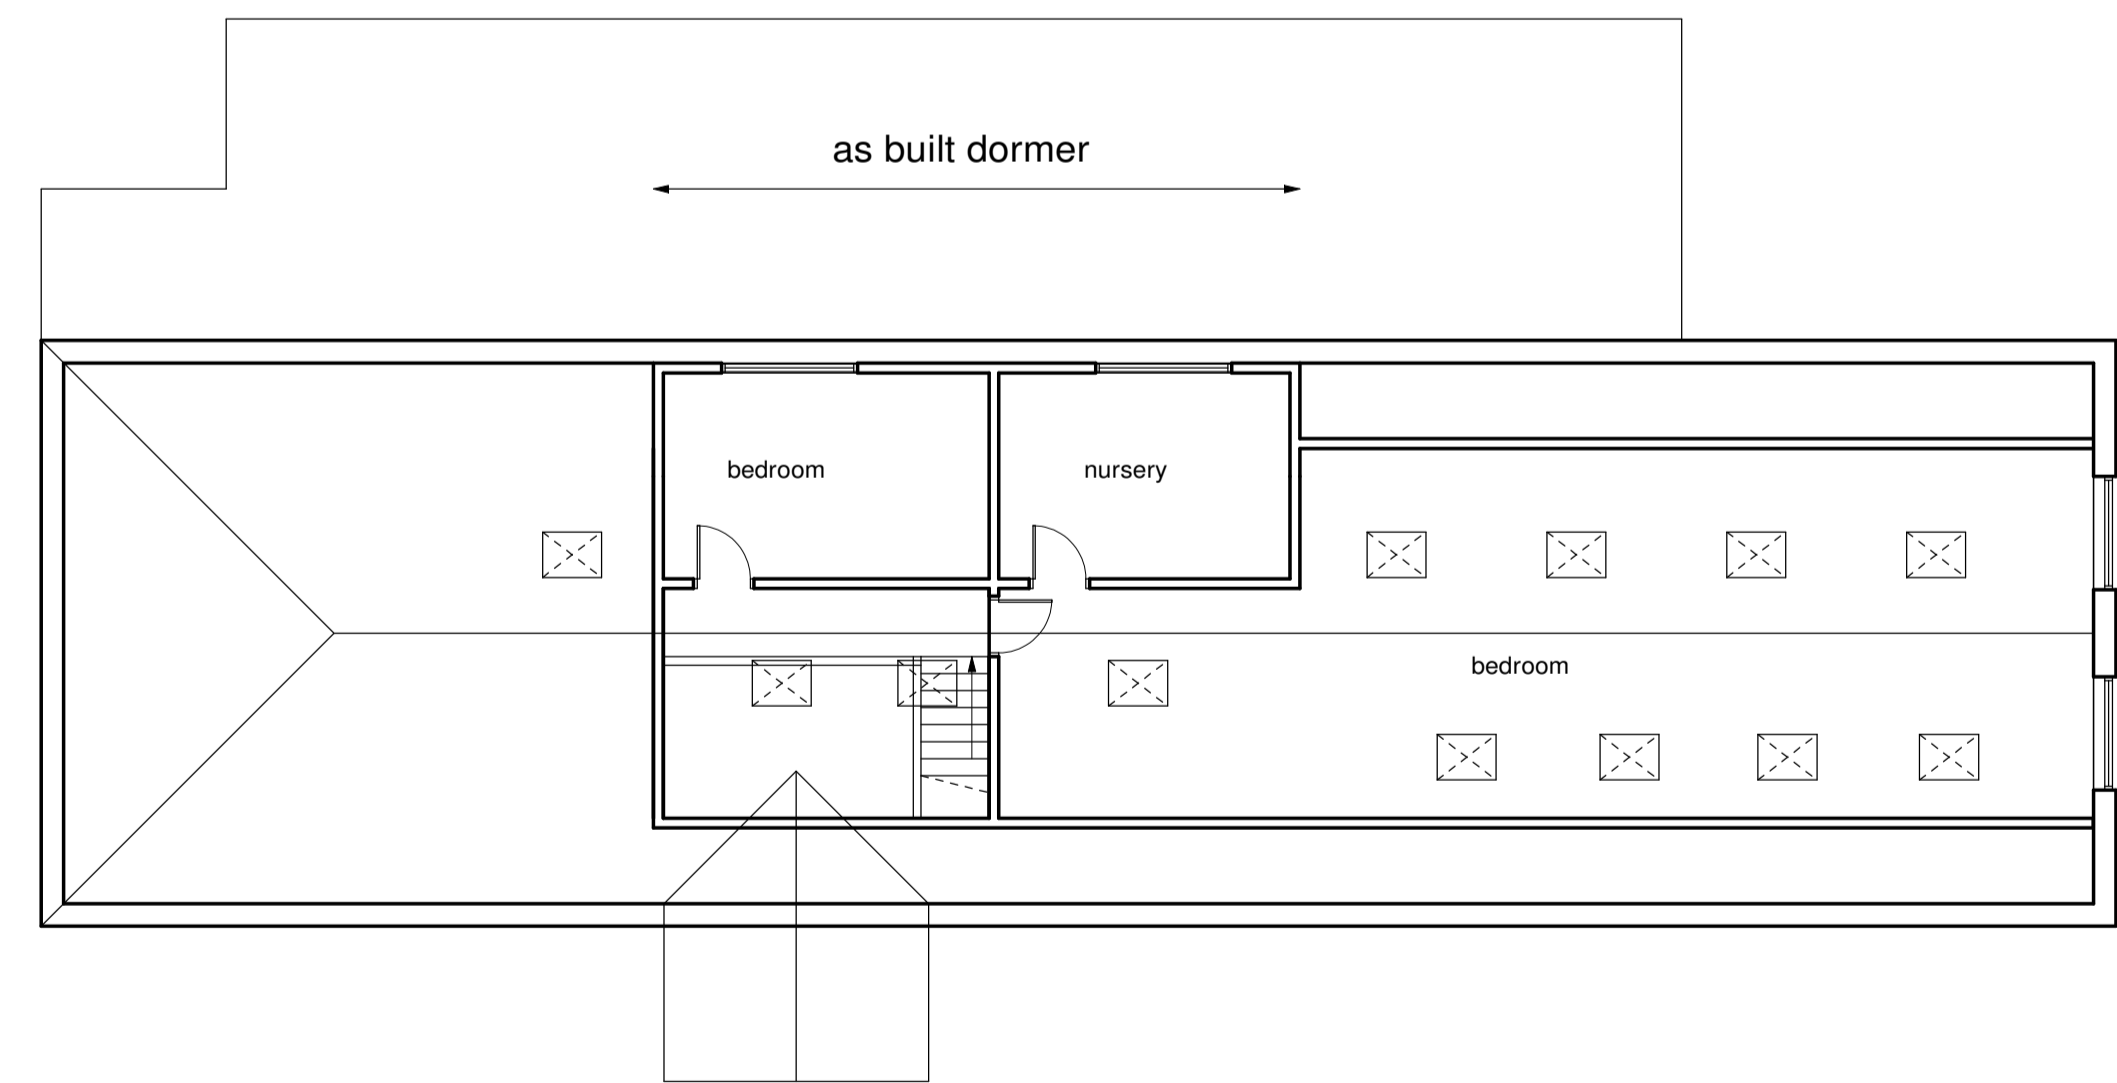

first floor:

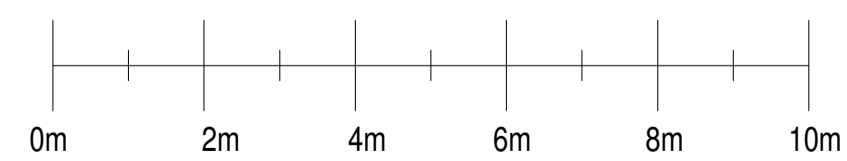

1:100 scale bar at A1

PLAN OF:
 ALTERATIONS TO ANCHOR PADDOCK,
 BACHELORS LANE,
 HOLT, Nr. WIMBORNE DORSET

(as built alterations: floor plans)

DRAWN BY:	J.G.h.
DRAWING NO:	4419:A(3E)
DATE:	NOVEMBER 2024
SCALE:	1:100

NOTE:

1. WORK TO FIGURED DIMENSIONS ONLY. DO NOT SCALE FROM DRAWINGS. SPECIFIC DIMENSIONS AVAILABLE ON REQUEST.
2. NO THIRD PARTY LIABILITY IS GIVEN. SALE OF PROPERTY DOES NOT TRANSFER RIGHTS OF USE. AVAILABLE ON AGREEMENT.
3. COPYRIGHT EXISTS ON ALL DRAWINGS. NO REPRODUCTION IN ANY FORM IS PERMITTED WITHOUT PRIOR CONSENT.
4. ALL WORK COMMENCED PRIOR TO FORMAL BUILDING REGULATION AND / OR PLANNING APPROVAL IS ENTIRELY AT CONTRACTOR'S / CLIENT'S OWN RISK.
- 5.

harriplan

CHARTERED BUILDING ENGINEERS
 25 ABBOTT ROAD, CHARMINSTER
 BOURNEMOUTH BH9 1EU. TEL/FAX 01202 549 590

E-Mail: jon@harriplan.com JON HARRISON M.C.A.B.E.

